

1386775

NATURAL GAS PIPELINE AND
REGULATOR STATION EASEMENT

Norman E. Meyer and Doris E. Meyer, Husband and Wife

for valuable consideration and mutual benefits received hereby grant(s), convey(s), and warrant(s) to THE WASHINGTON WATER POWER COMPANY, a corporation, as Grantee, its successors and assigns, an easement over, across, under and through the following described property of the Grantor(s) in Kootenai County, State of Idaho, to-wit:

*N.E.M.
D.E.M.*

A strip of land Ten (10) feet wide being located along the West side of Government Lot Seven (7) together with 20 foot by 20 foot rectangular parcel of land located in the South 30 feet, more or less, of the West 30 feet, more or less, of said Government Lot Seven (7). All in the Southwest Quarter (SW1/4) of Section Six (6), Township Fifty-One (51) North, Range Four (4) West, B.M., Kootenai County, State of Idaho. EXCEPT ROADS.

It is understood and agreed that said easement covers the right to install, operate, maintain, repair, refurbish, inspect and remove a six (6) inch natural gas pipeline together with associated appurtenances and a four (4) inch natural gas pipeline together with associated appurtenances on said Ten (10) feet wide strip and the right to place a natural gas regulator station together with associated appurtenances on said South Thirty (30) feet of the above described property. Said pipeline will be installed at a depth equal to or greater than 36 inches. All as shown more approximately on the attached print which by this reference is made a part hereof.

...together with the right to inspect said line, and prohibit dwelling within Ten (10) the easement strip and to remove brush and trees that may interfere with the construction, maintenance and operation of same.


Norman E. Meyer
Doris E. Meyer

STATE OF Idaho)
COUNTY OF Kootenai): ss.

On this day personally appeared before me Norman E. Meyer
and Doris E. Meyer, Husband and Wife

to me known to be the individual(s) described in and who executed the within and foregoing instrument and acknowledged that they signed the same as their free and voluntary act and deed, for the uses and purposes therein mentioned.

Given under my hand and official seal this 25th day of July 19 94

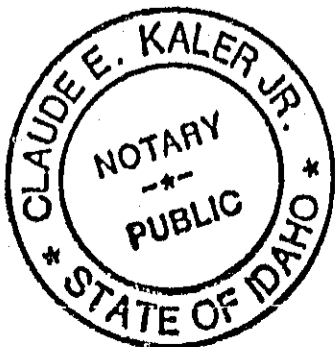


Claude E. Kaler Jr.
NOTARY PUBLIC in and for the State of
Idaho residing at Spokane, Washington
My Commission Expires 31 May 2000

1386775

WORK AUTHORIZATION


LOCATION: COOK COUNTY, IOWA	OWNER'S NAME AND ADDRESS: BOEKEL RD & HWY. #41, 4" x 6" MAIN EXTENSION	S.F.:	ACRES:	EST. NO. (1111):	TRK:
CITY: COOK COUNTY		7185	1311.00	775, 671	450
DATE: 8-1-91					
PROJECT NO. 1386775					
DESCRIPTION AND EXTENT: INSTALL 12,000' 4" STEEL W.P. MAIN, 1500' 4" x 4" I.P. MAIN & 121' 2" TO 2" I.P. MAIN, 2780' 4" H.P. MAIN TO EXISTING PLAN					
DATE OF ORDER: 8-1-91	DATE OF WORK: 8-1-91	DATE OF PAYMENT: 8-1-91	DATE OF COMPLETION: 8-1-91	DATE OF INSPECTION: 8-1-91	DATE OF BILLING: 8-1-91

PIPE	CONDITION	REMARKS
12" Steel	Good	
8" Steel	Good	
6" Steel	Good	
4" Steel	Good	
3" Steel	Good	
2" Steel	Good	
1.5" Steel	Good	
1" Steel	Good	
0.75" Steel	Good	
0.5" Steel	Good	
0.375" Steel	Good	
0.25" Steel	Good	
0.1875" Steel	Good	
0.125" Steel	Good	
0.0625" Steel	Good	

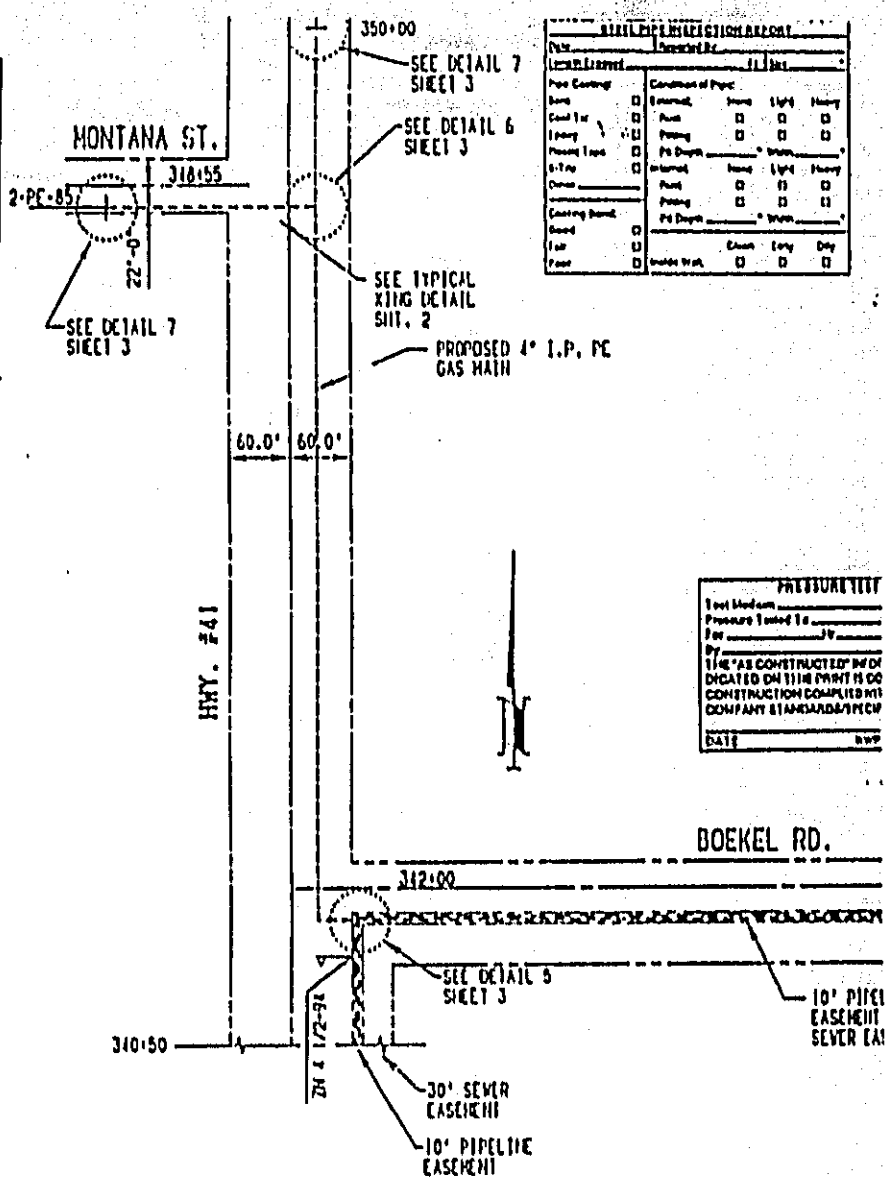

PRESSURE TEST
 Test Medium: _____
 Pressure Tested To: _____
 For: _____
 BY: _____
 TIME AS CONSTRUCTED AND INDICATED ON THIS PRINT IS GOVERNING. CONSTRUCTION COMPLIES WITH COMPANY STANDARDS AND PRACTICES.
 DATE: _____

NO.	QTY	SIZE	STOCK NO.	DESCRIPTION
1	2	6"		WROUGHT, EV-11 GATE VALVE, 500 PSI, W X V
2	2	6"	770-2067	90° WELD ELBOW - STD WALL
3	1	6"		WELD CAP - STD WALL
4	1	4"		11-17621 BOTTOM-OUT STOPPER FITTING
5	1	4"	770-0956	WELD CAP - STD WALL
6	2	4"	770-2057	90° WELD ELBOW - STD WALL
7	2	6"	770-8666	ROCKWELL FIG. 81211 PLASTIC VALVE
8	2	6"	770-7780	P.F. TEE
9	1	6"	770-0918	P.F. CAP
10	2	6"x1"	770-7087	P.F. REDUCER
11	2	4"	770-8660	ROCKWELL FIG. 81211 PLASTIC VALVE
12	2	4"	770-0900	P.F. TEE
13	2	4"	770-7885	P.F. TEE
14	1	6"	770-2218	TRANSITION FITTING P.F. TO STEEL
15	1	4"	770-1835	P.F. ELBOW
16	2	4"x2"	770-1560	P.F. REDUCER
17	2	2"	770-1400	P.F. COUPLING
18	1	11"	770-0625	VALVE BOX
19	11,800'	6"		PIPE, STEEL, API-5L, GRADE B OR X-42, 0.280" WALL THICKNESS, C & V
20	2,780'	4"		PIPE, STEEL, API-5L, X-42, 0.188" WALL THICKNESS, C & V
21	2,000'	6"	770-6377	PIPE, P.
22	6,300'	4"	770-6325	PIPE, P.
23	20'	2"	770-6310	PIPE, P.
24	8,500'	1/4"	283-1002	YELLOW BRASS WIRE, AVG S&D
25	1	3'	770-7890	YELLOW BIRCH PINE TEST STATION
26	1	3'	578-0765	PVC CONDUIT 4" LONG
27	12	12	662-8310	FIBERGLASS GAS WARNING SIGN
28	12	1/2"	770-0170	WIRE ANCHOR
29	200'	1/2"	283-1020	BLACK WIRE, CU, 11801, S&D
30	3	4"	770-8725	WROUGHT, EV-11 GATE VALVE, 500 PSI W X V
31	1	6"x2"	770-6812	WELD REDUCING, STD WALL
32	1	4"	770-7668	WELD TEE, STD WALL
33	1	6"		WELD TEE, STD WALL
34	3	1/2"	770-1325	H.P. COUPLING
35	3	1/2"		PIPE PLUG, SCHED. 80
36	4	1/4"	770-0172	MAGNESIUM ANODES

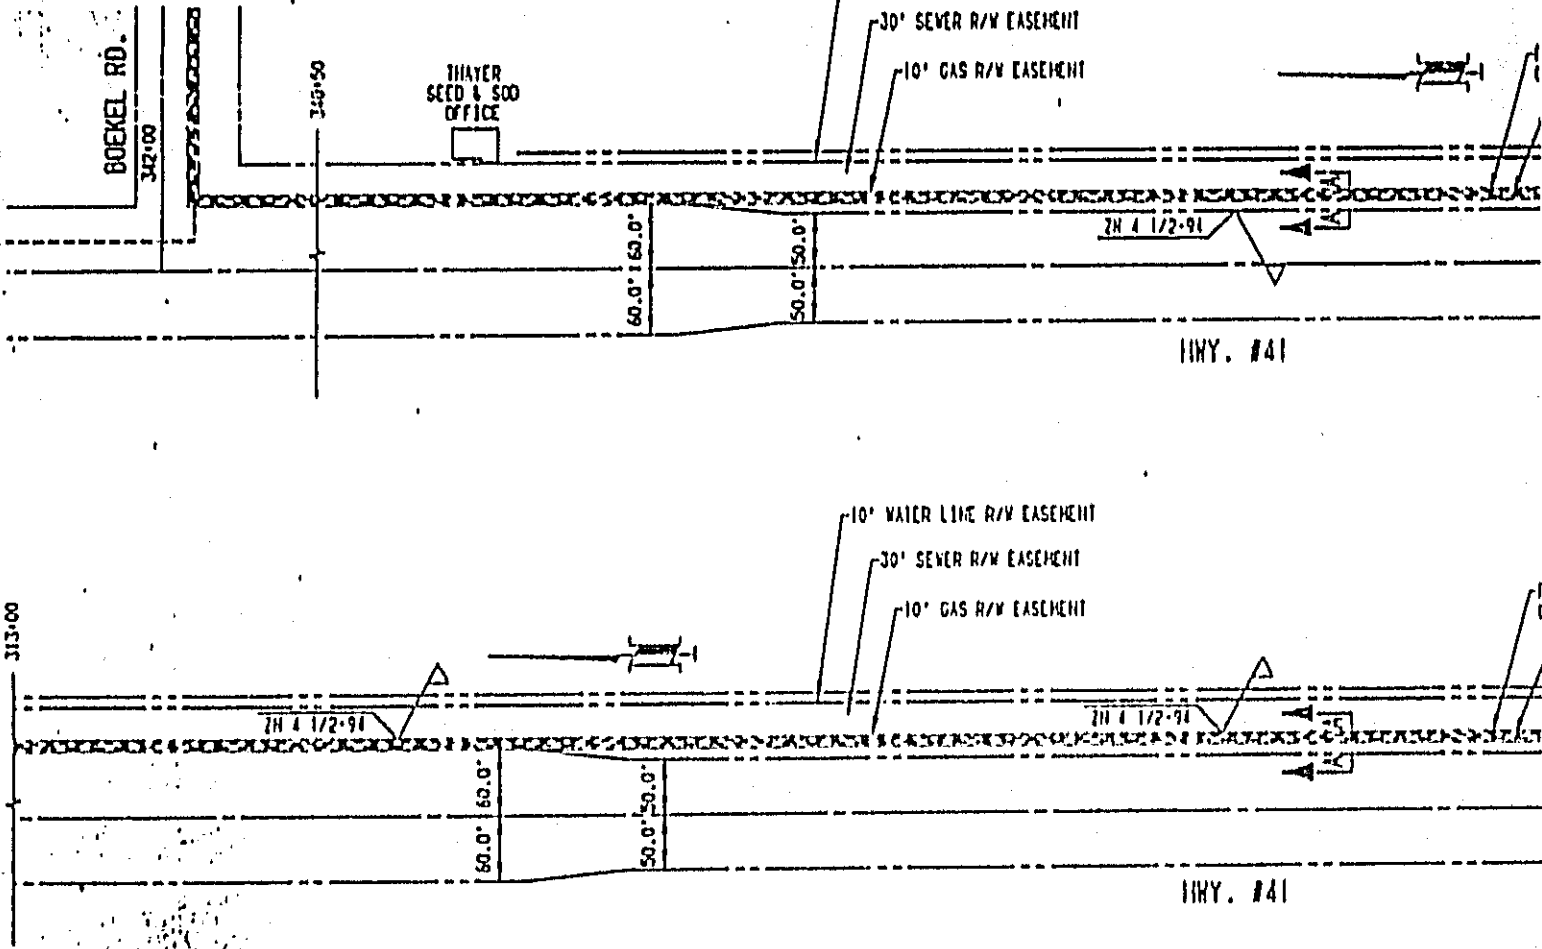

1386775

W.O. # 7185-1376.00 . POY. 650

NOTES:

- 1) ALL WORK SHALL BE IN ACCORDANCE WITH THE WWP CO SPECIFICATIONS & THESE DRAWINGS.
- 2) EXISTING UTILITY & CONDUIT INFORMATION SHOWN ON THE DRAWINGS IS INCOMPLETE & NOT INTENDED TO PROVIDE DETAILED UTILITY LOCATION INFORMATION. THE CONTRACTOR IS RESPONSIBLE FOR LOCATING ALL UTILITIES.
- 3) PIPELINE CONSTRUCTION SHALL PROVIDE 12 INCHES OF CLEARANCE FROM ALL EXISTING UTILITIES.
- 4) THE CONTRACTOR SHALL CONSTRUCT ALL CHANGES IN DIRECTION BY FIELD BENDING THE PIPE USING AS LARGE A RADIUS AS PRACTICAL UNLESS THE DRAWINGS CALL FOR A FITTING OR FACTORY BEND. THE DIFFERENCE BETWEEN MIN. & MAX. O.D. SHALL NOT EXCEED 5/32". ELBOWS SHALL BE LONG RADIUS UNLESS NOTED OTHERWISE.

- 5) INSTALL GAS WARNING SIGNS AT 1000' INTERVALS ALONG MAIN.
- 6) 4" & 6" STEEL HADP = 500 PSIG, HOP = 250 PSIG
4" & 6" PE HADP = 60 PSIG, HOP = 60 PSIG
PRESSURE TEST 4" & 6" STEEL AT 750 PSIG
4" & 6" PE AT 90 PSIG; PRESSURE TEST WITH WATER, AIR OR INERT GAS FOR 24 HRS MIN. W/PRESSURE RECORDING CHART. TEST CHART SHOULD BE LOCATED AT AREA OF MAX. ELEVATION TO ASSURE ENTIRE LINE IS SUBJECTED TO MIN. TEST PRESSURE.
- 7) PIG. & DRY GAS MAIN TO REMOVE ALL WATER PRIOR TO PLACING IN SERVICE.
- 8) WWP TO MAKE TIE-IN'S & BUILD REG. STATION AT PGT TAP ON BOEKEL ROAD.
- 9) CONTRACTOR TO CONTACT DON MILLER, CATHODIC SPECIALIST (PH. 489-0500, EXT. 4198, PAGER 484-0756) FOR PRECISE LOCATIONS OF CATHODIC TEST LEADS ON MAIN.

STATE OF IDAHO
COUNTY OF KOOTENAI } SS

AT THE REQUEST OF

WWP
FEB 14 11 PM '95

COOPER
DEPUTY
FEE \$ 900

DATE
BY
WWP INSPECTOR

FAILURE TEST
Test Medium _____ PSIG
Pressure Tested To _____ PSIG
For _____ Min.
By _____
THE "AS CONSTRUCTED" INFORMATION INDICATED ON THIS PRINT IS CORRECT. ALL CONSTRUCTION COMPLIES WITH CURRENT COMPANY STANDARDS/SPECIFICATIONS.
DATE _____ WWP INSPECTOR

PRESSURE TEST
Test Medium _____ PSIG
Pressure Tested To _____ PSIG
For _____ Min.
By _____
THE "AS CONSTRUCTED" INFORMATION INDICATED ON THIS PRINT IS CORRECT. ALL CONSTRUCTION COMPLIES WITH CURRENT COMPANY STANDARDS/SPECIFICATIONS.
DATE _____ WWP INSPECTOR

